
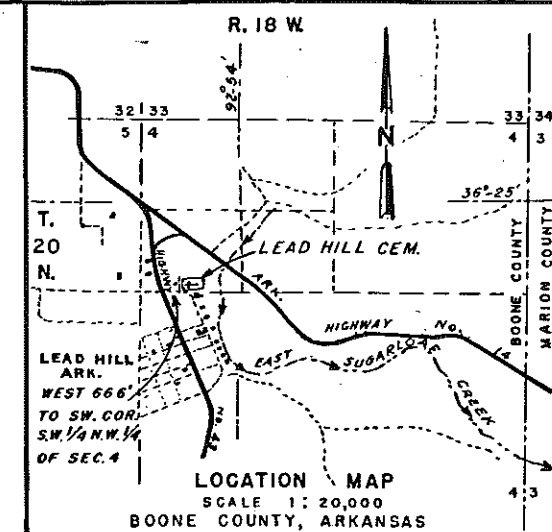


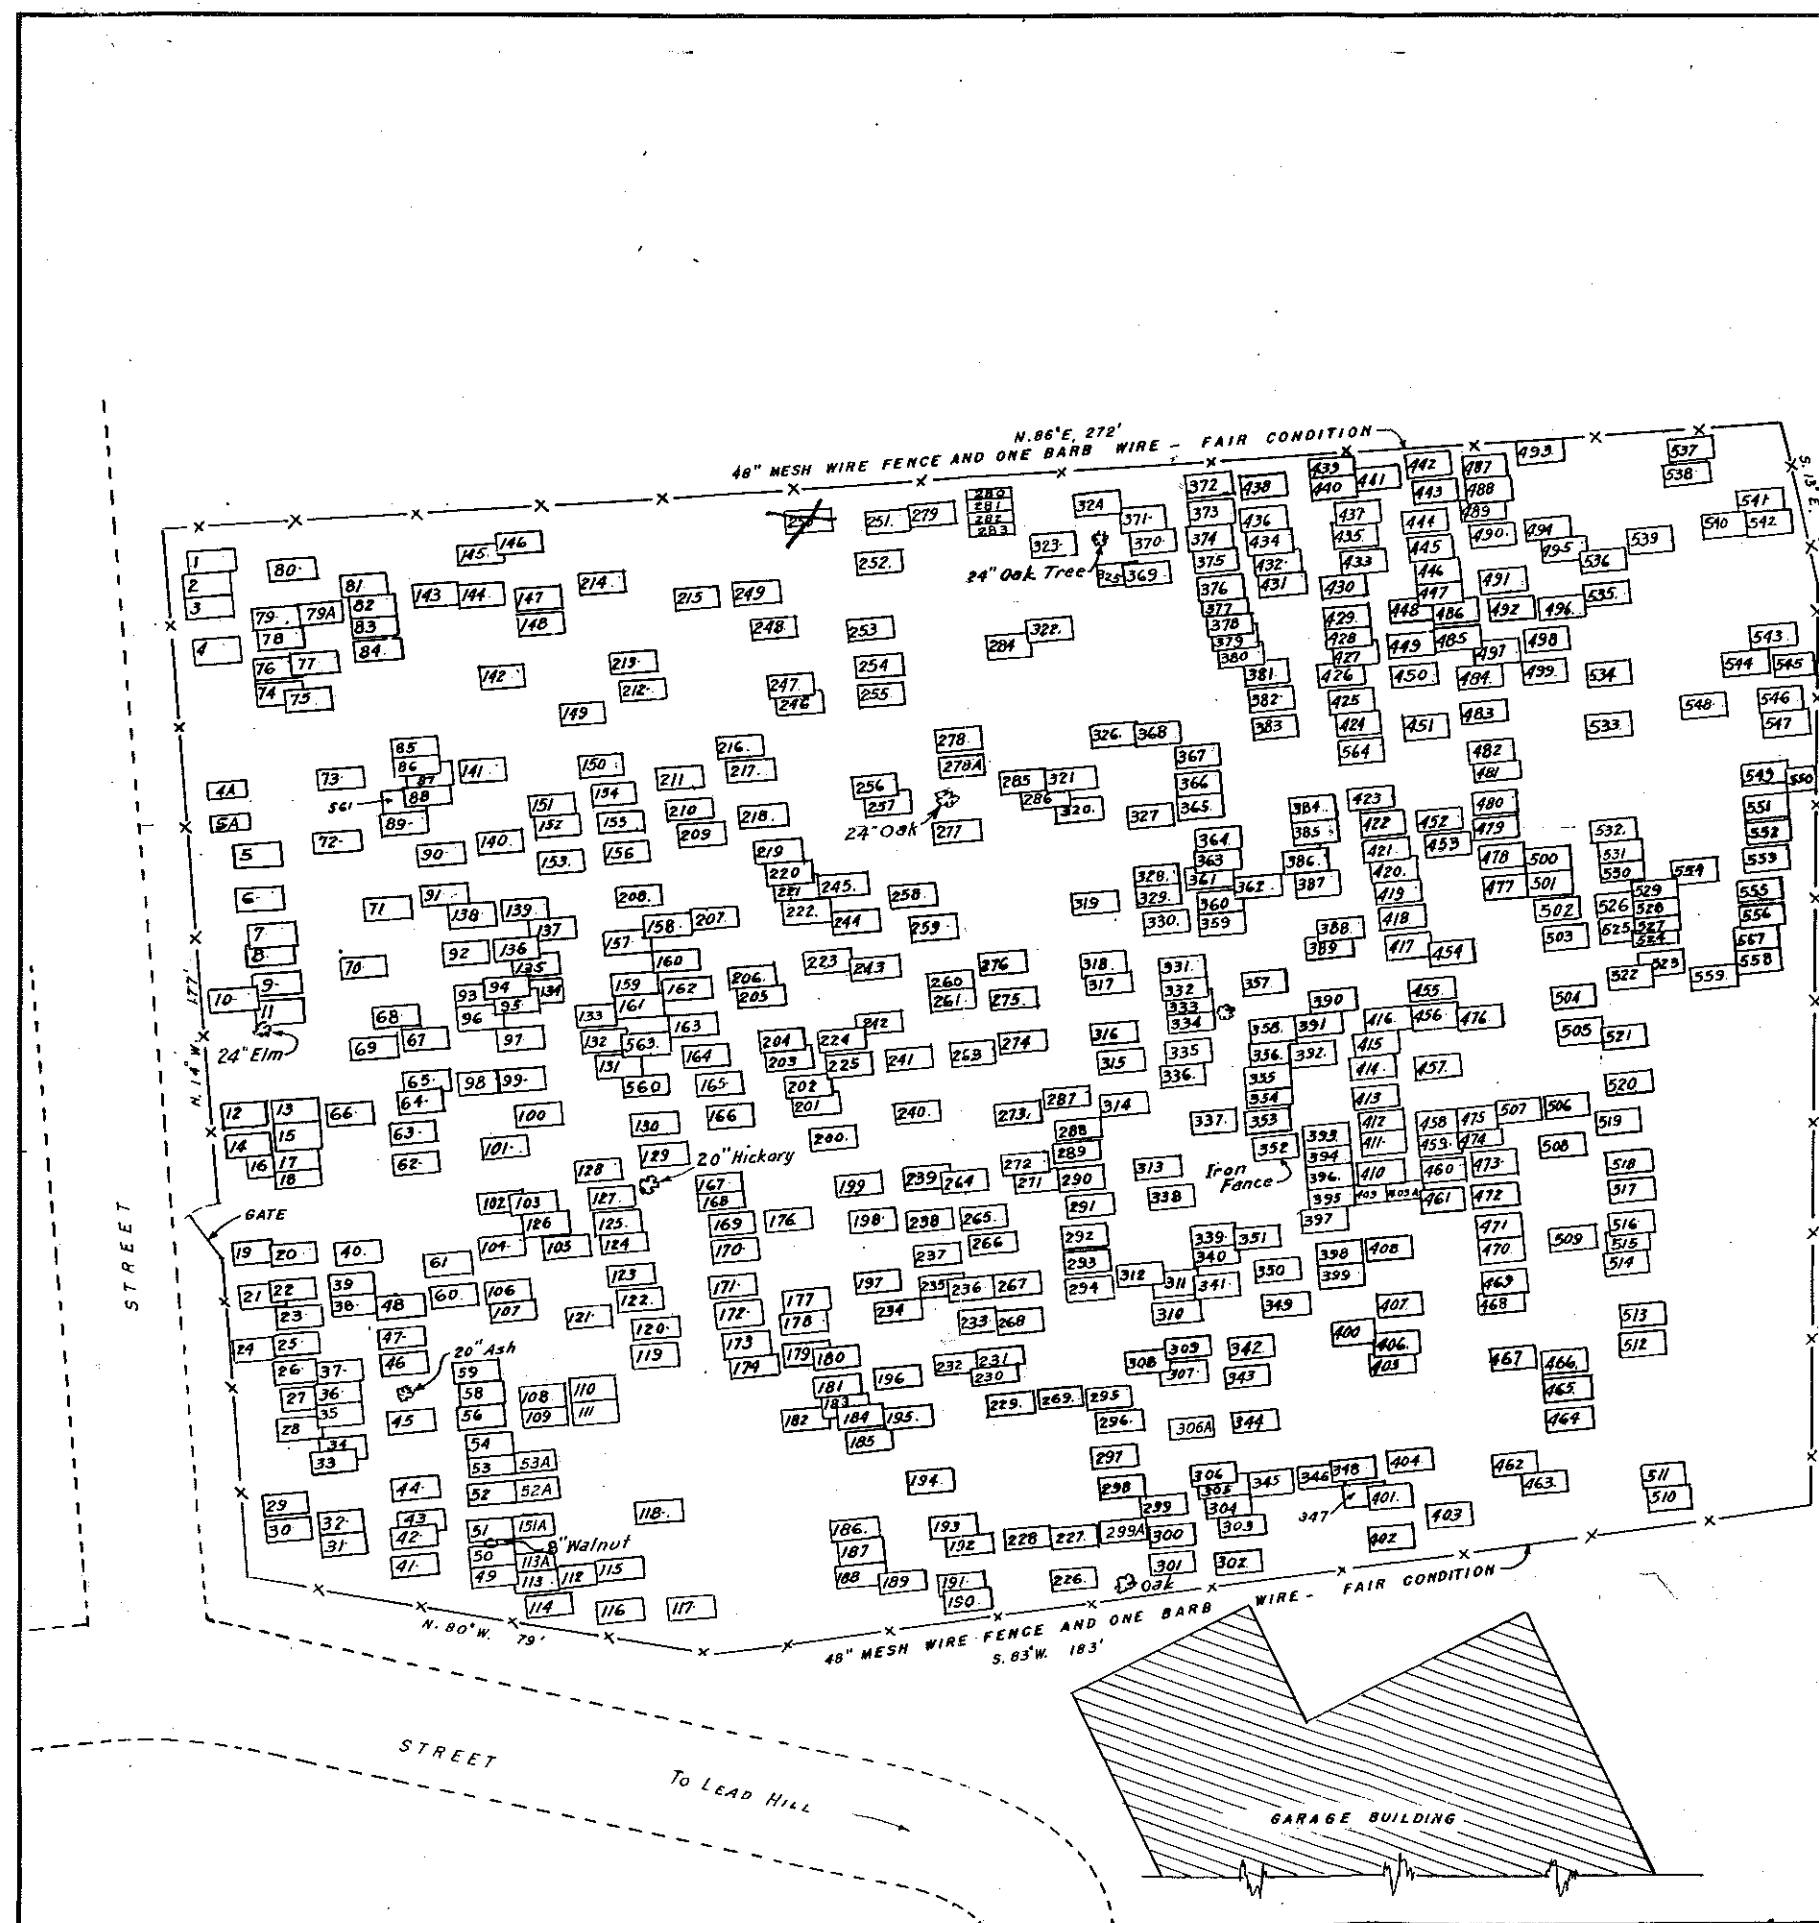

CEM. ELEV 660-870

GRAVES FOUND

GRAVE NO.	EXISTING CEMETERY NAME	RELO. CEM. B.S.C-8-R		
		TIER NO.	BLOCK NO.	LOT NO.
151 A	UNKNOWN	9	9	3
79 A	"	9	9	5
113 A	"	4	8	4
53 A	"	4	8	2
4 A	"	4	8	7
5 A	"	4	8	9
306 A	"	4	8	8
52 A	"	4	8	10
299 A	NANCY BLALOCK	14	9	2

RECORD DRAWING AS CONSTRUCTED

WHITE RIVER WATERSHED WHITE RIVER, ARKANSAS

BULL SHOALS RESERVOIR

CEMETERY RELOCATION

LEAD HILL CEMETERY

B.S.13

IN 16 SHEETS SCALE: 1:240 SHEET NO. 2

20 0 20 40 60

SCALE OF FEET

LITTLE ROCK DIST., LITTLE ROCK, ARK., MAY, 1950

SUBMITTED: APPROVAL RECD: APPROVED:

HEAD DESIGN BR. CHIEF ENGR. DIV. LT. COL. CORPS ENGRS. ACT. DISTRICT ENGR.

DRAWN A.M.H. TRACED A.M.H. CHECKED H.R.B.

SERIAL 5926

FILE 139/1672