
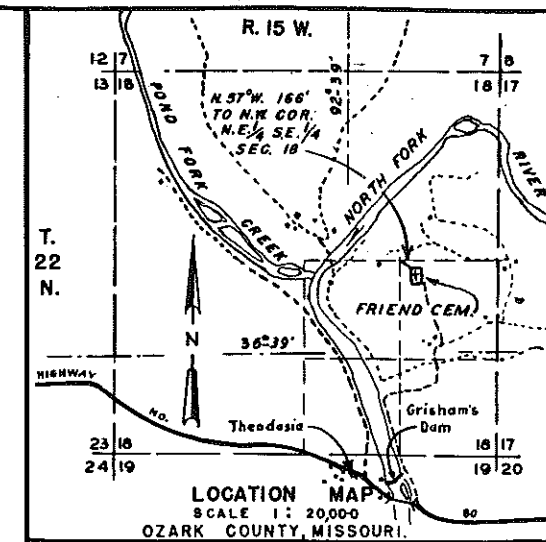


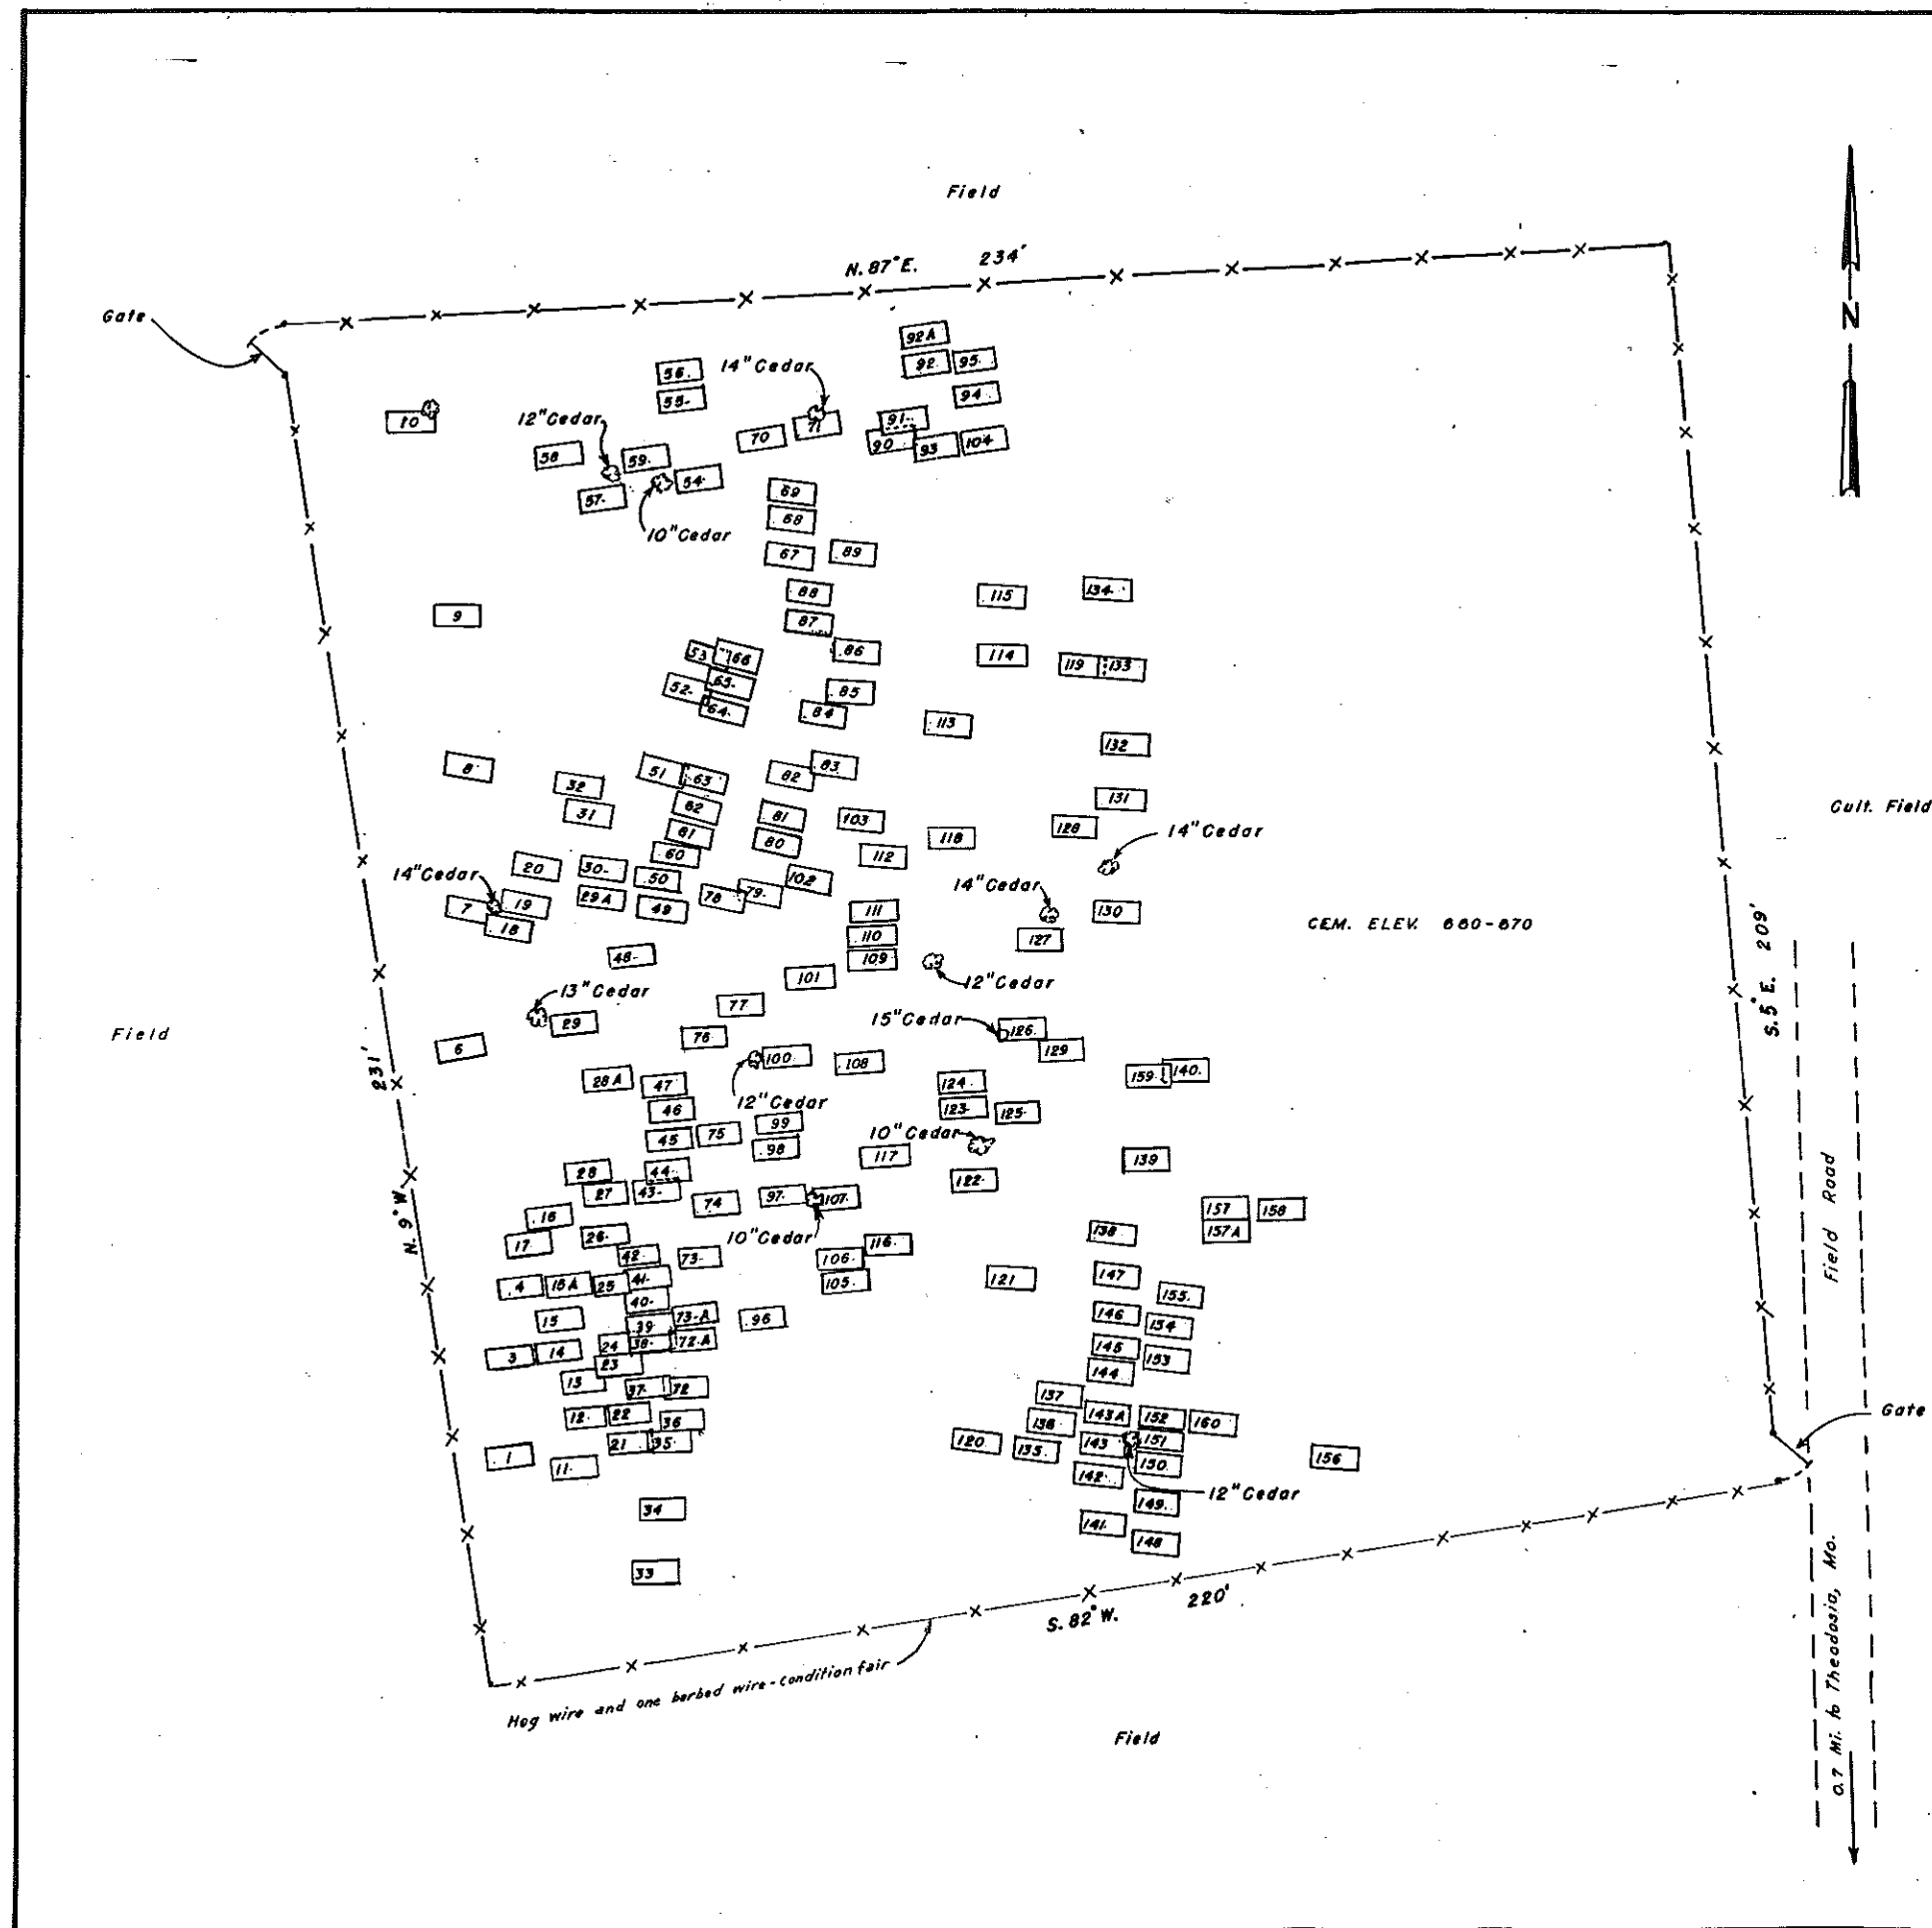

NOTE

1. GRAVES IN THIS CEMETERY TO BE RELOCATED IN NEW FRIEND CEMETERY, B.S.C.-10-R. SEE SHEET 10 FOR LAYOUT AND SHEET 3 FOR SCHEDULE OF RELOCATION.

RECORD DRAWING AS CONSTRUCTED

12-21-50

WHITE RIVER WATERSHED WHITE RIVER, ARKANSAS

BULL SHOALS RESERVOIR

CEMETERY RELOCATION

FRIEND CEMETERY B.S.-16

IN 12 SHEETS SCALE: 1:240 SHEET NO. 2

20 40 60

SCALE OF FEET

LITTLE ROCK DIST., LITTLE ROCK, ARK., MAY, 1950

SUBMITTED: APPROVAL REC'D: APPROVED:

HEAD DESIGN BR. CHIEF, ENGRG. DIV. LT. COL. CORPS ENGRS.

DRAWN A.M.H. ACT. DISTRICT ENGR.

TRACED SERIAL 5955

CHECKED H.R.B. FILE 139/1692