
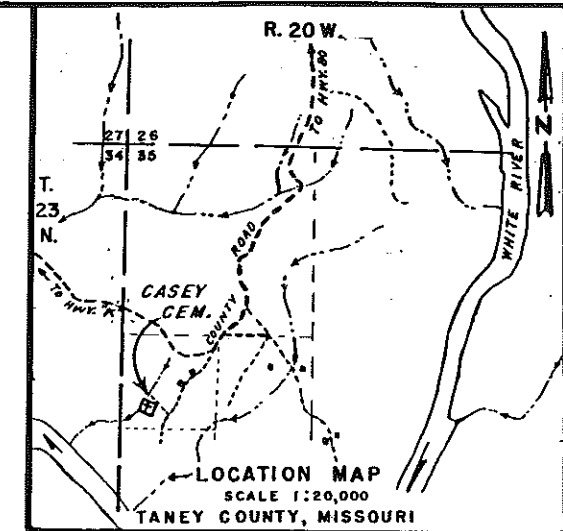


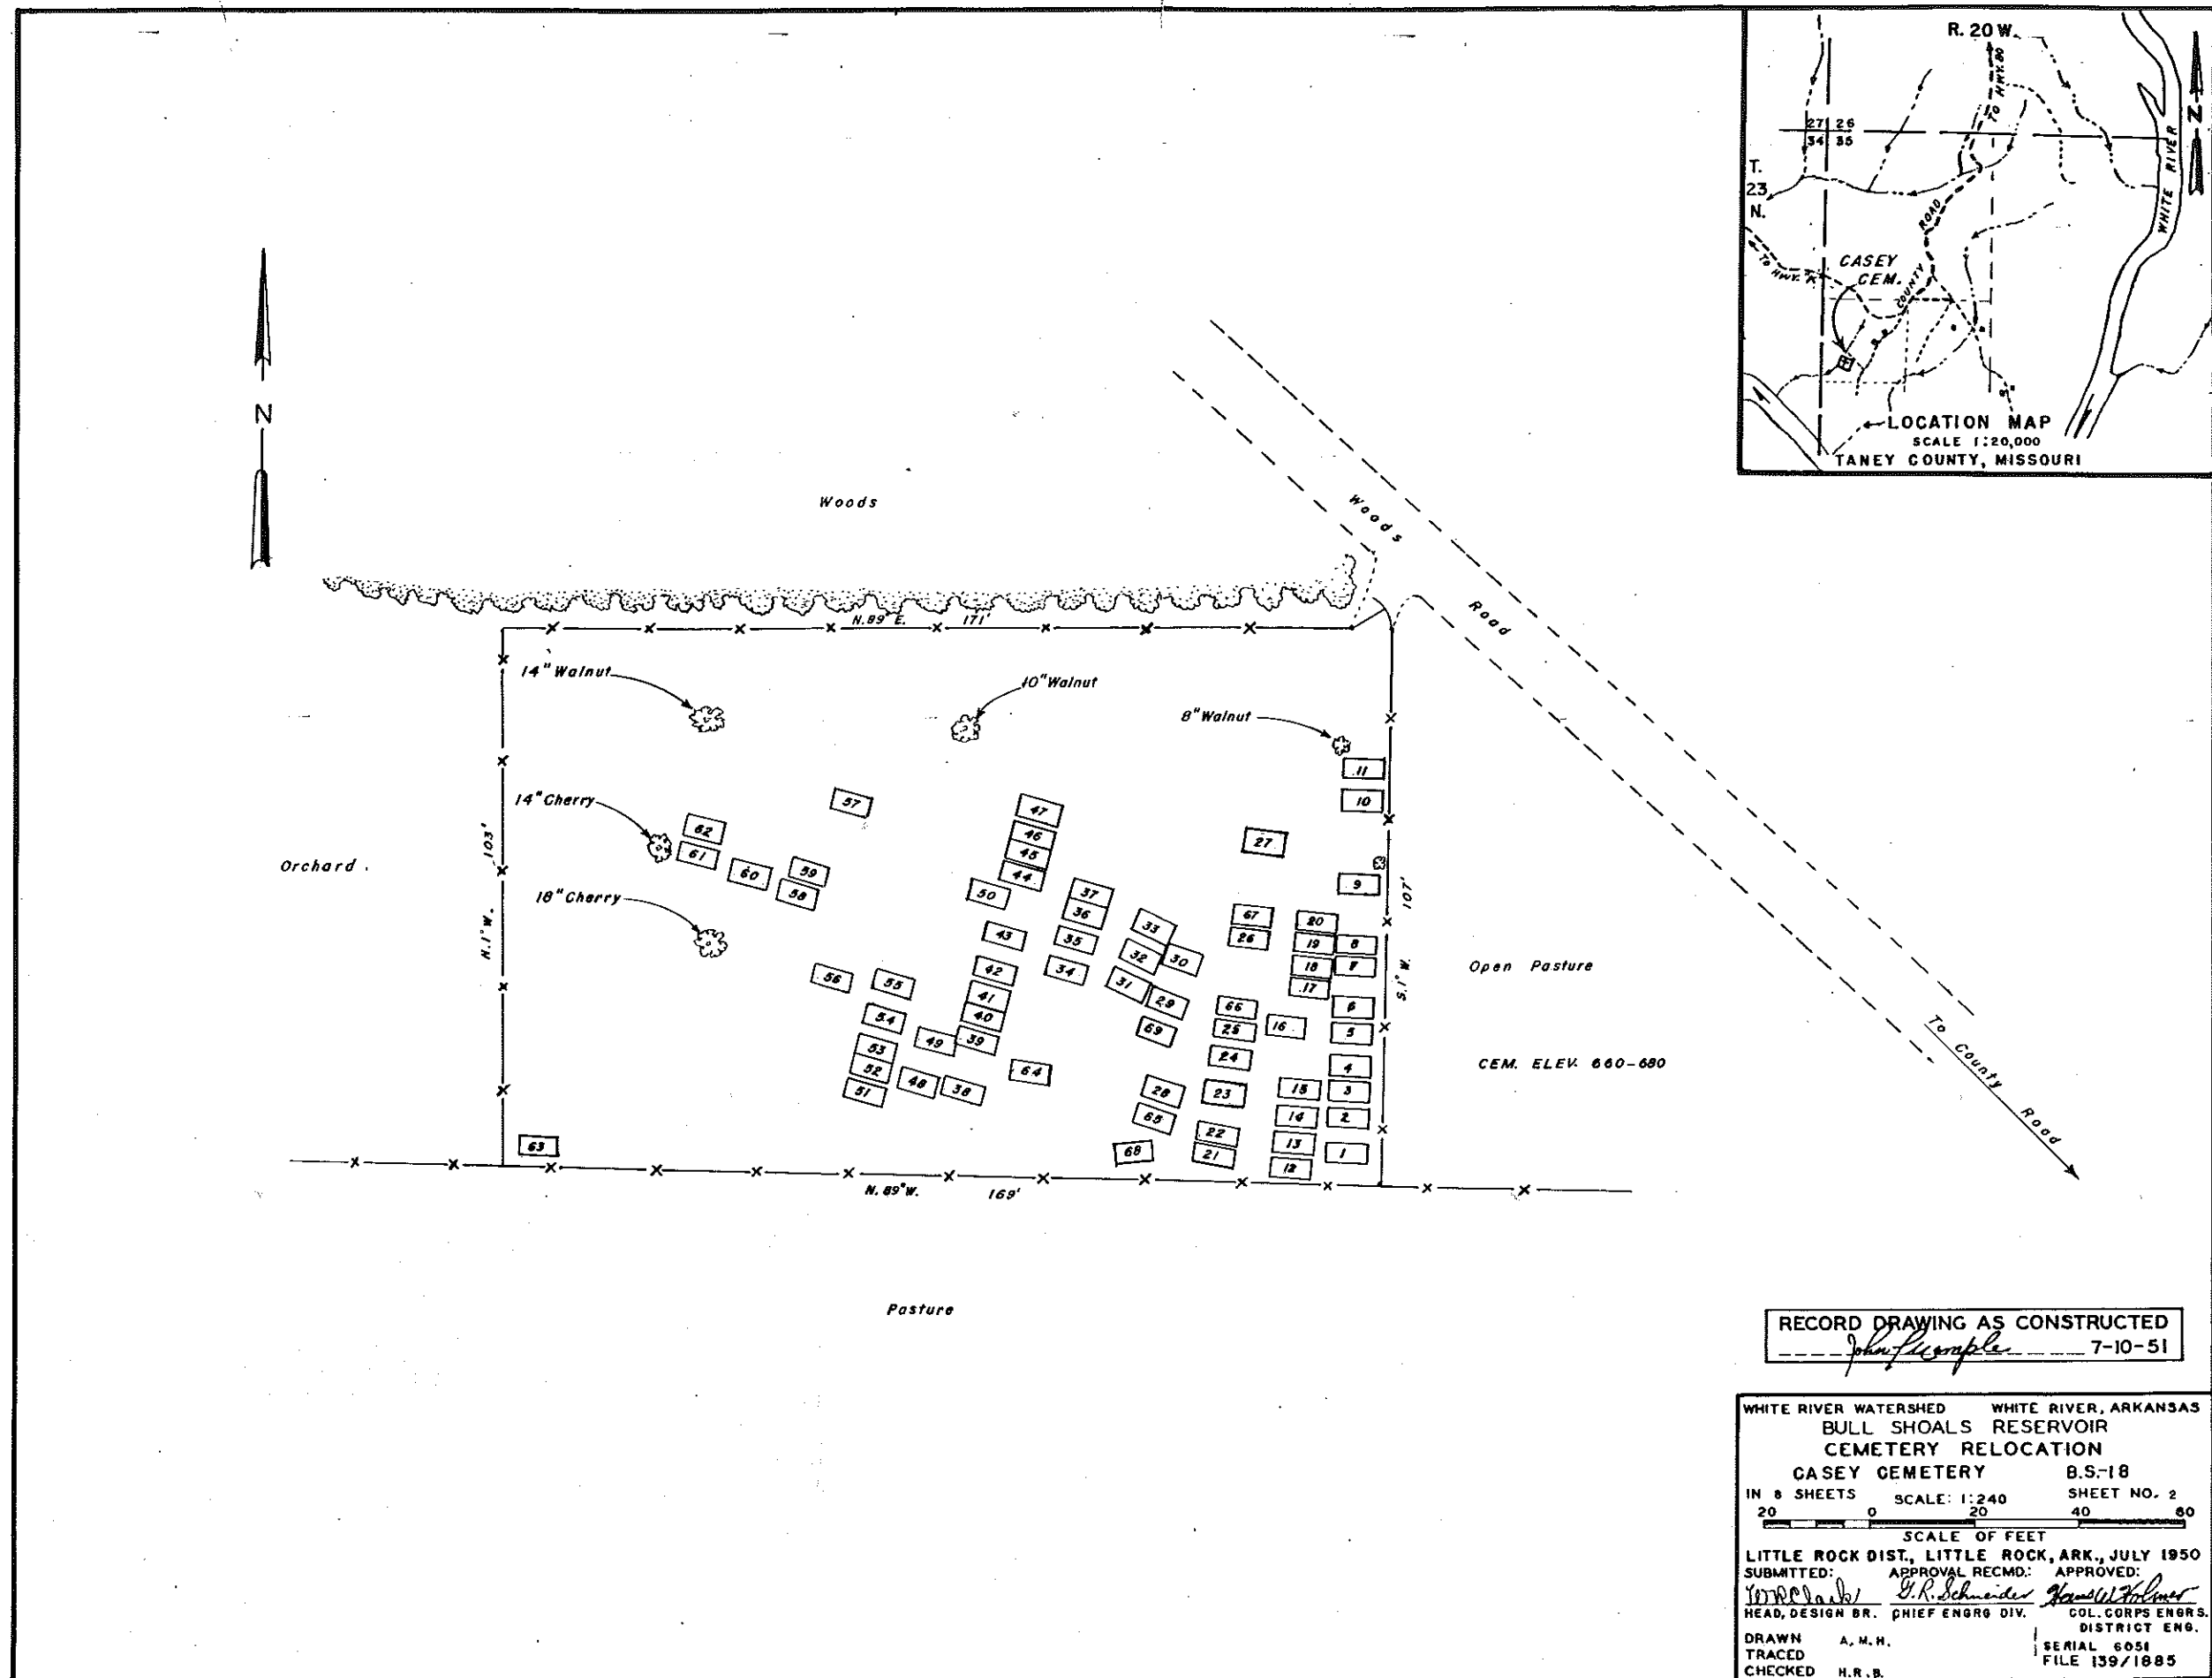

RECORD DRAWING AS CONSTRUCTED

WHITE RIVER WATERSHED WHITE RIVER, ARKANSAS
BULL SHOALS RESERVOIR
CEMETERY RELOCATION
CASEY CEMETERY B.S.-18
IN 8 SHEETS SCALE: 1:240 SHEET NO. 2
20 0 20 40 60
SCALE OF FEET
LITTLE ROCK DIST., LITTLE ROCK, ARK., JULY 1950
SUBMITTED: APPROVAL REC'D: APPROVED:
HEAD, DESIGN BR. CHIEF ENGRS. DIV. DISTRICT ENGR.
DRAWN A. M. H. SERIAL 6051
TRACED FILE 139/1885
CHECKED H. R. B.