
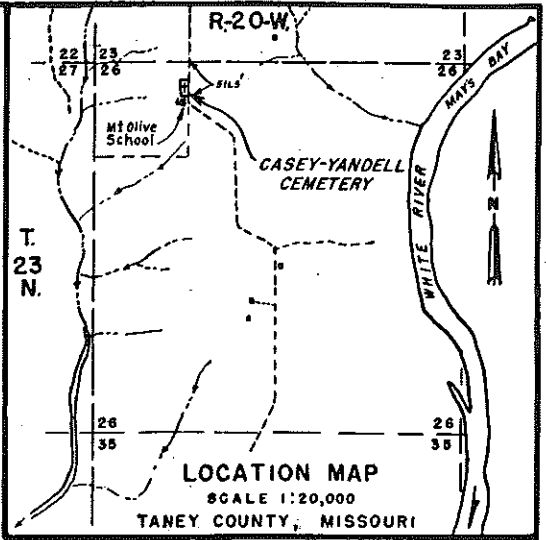


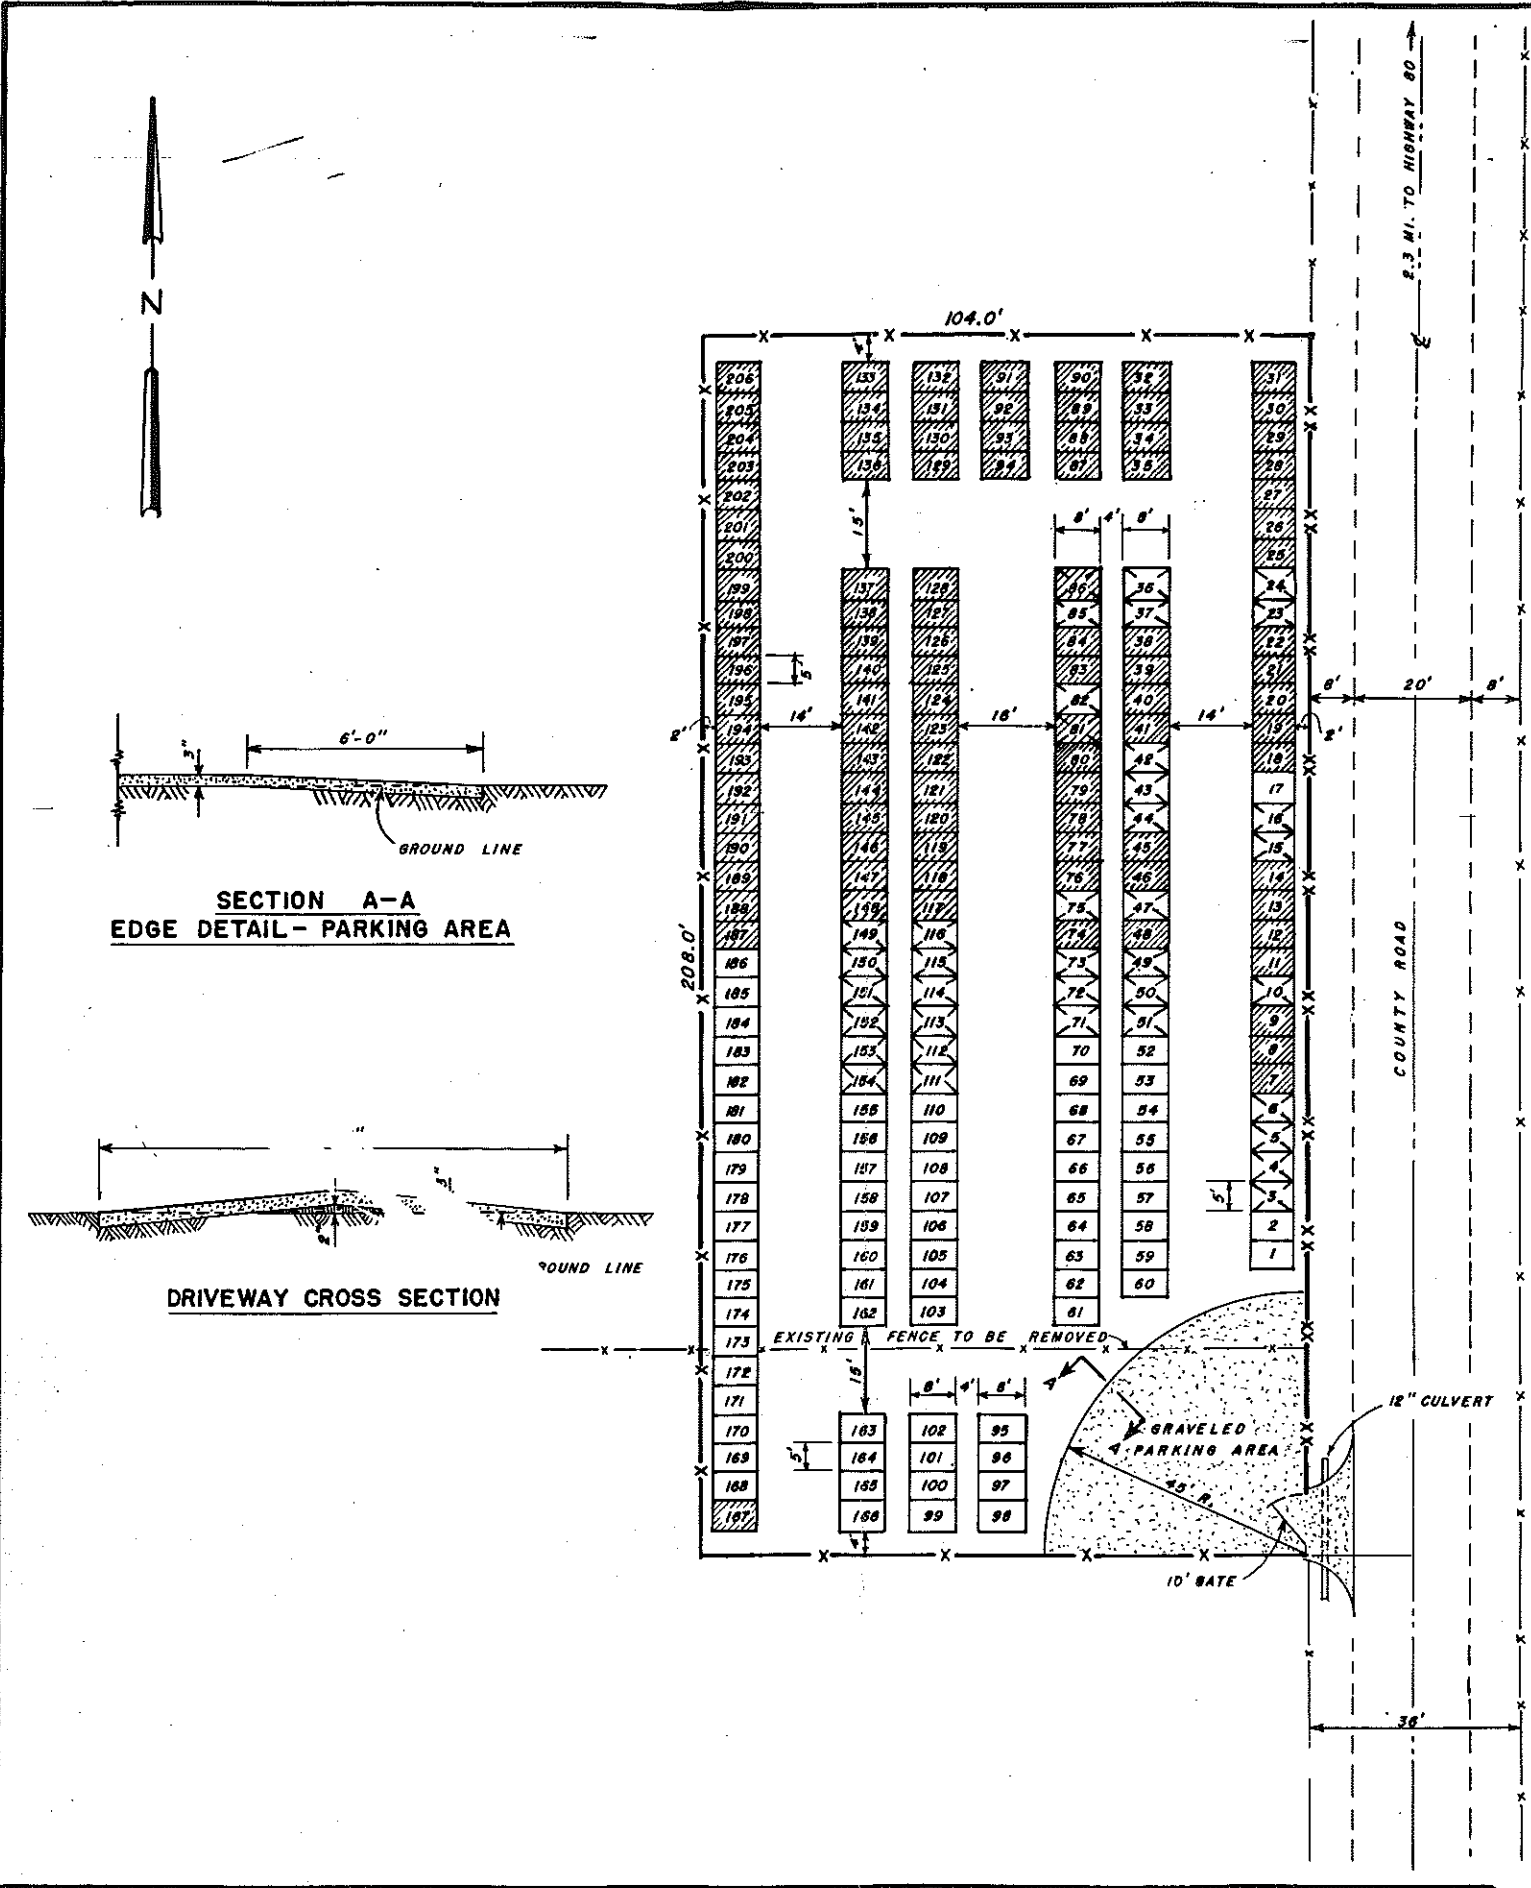

- NOTES:
1. SEE SHEETS 3, 4, AND 6 FOR SCHEDULES OF RELOCATION.
 2. SEE STANDARD SHEETS FOR DETAILS OF BOXES, MARKERS AND FENCE.
 3. SURFACING MATERIAL FOR DRIVEWAY AND PARKING AREA TO BE WELL GRADED RIVER GRAVEL OF 1/2" MAXIMUM SIZE OR EQUIVALENT AS APPROVED BY CONTRACTING OFFICER.
 4. CONTRACTOR TO REMOVE APPROXIMATELY 312' OF EXISTING FENCE AND TIE REMAINING FENCE TO NEW FENCE.

- LEGEND:
- GRAVES MOVED FROM OTHER CEMETERIES UNDER THIS CONTRACT.
 - LOTS RESERVED FOR RELATIVES.
 - LOTS FOR FUTURE BURIAL (NOT RESERVED)
 - NEW FENCE TO BE CONSTRUCTED
 - EXISTING FENCE TO BE REPLACED
 - EXISTING FENCE

RECORD DRAWING AS CONSTRUCTED

7-10-51

REVISION	DATE	DESCRIPTION	BY
1	12-30-50	GRAVES FROM PRUITT CEM. INCLUDED	LM

WHITE RIVER WATERSHED WHITE RIVER, ARKANSAS
BULL SHOALS RESERVOIR
CEMETERY RELOCATION
CASEY-YANDELL CEMETERY, BSC-13-R.

IN 8 SHEETS SCALE: 1:240 SHEET NO. 5

20 0 20 40 60

SCALE OF FEET

LITTLE ROCK DIST, LITTLE ROCK, ARK., JULY 1950

SUBMITTED: APPROVAL RECD: APPROVED:

W. R. W. B. E. R. Schneider H. W. H. W. B. E. R. Schneider

HEAD, DESIGN BR. CHIEF, ENGRG. DIV. COL. CORPS ENGRS. DISTRICT ENGINEER

DRAWN A.M.H. SERIAL 6051

TRACED FILE 139/1886

CHECKED H.R.B.