




NOTE:
1. GRAVES IN THIS CEMETERY TO BE RELOCATED IN
NEW KISSEE MILLS CEMETERY, BSC-14-R. SEE
SHEET 9 FOR LAYOUT AND SHEET 5 FOR
SCHEDULE OF RELOCATION.

RECORD DRAWING AS CONSTRUCTED
7-10-51

WHITE RIVER WATERSHED
BULL SHOALS RESERVOIR
CEMETERY RELOCATION
WILLIAMS CEMETERY
B.S.-19
IN 11 SHEETS SCALE: 1:240 SHEET NO. 4
SCALE OF FEET
LITTLE ROCK DIST., LITTLE ROCK, ARK., SEPT. 1950
SUBMITTED: APPROVED:
HEAD, DESIGN BR., CHIEF, ENGRS. DIV.
DRAWN: A.M.H.
CHECKED: H.R.B.
SERIAL: 6083
FILE 159/1894

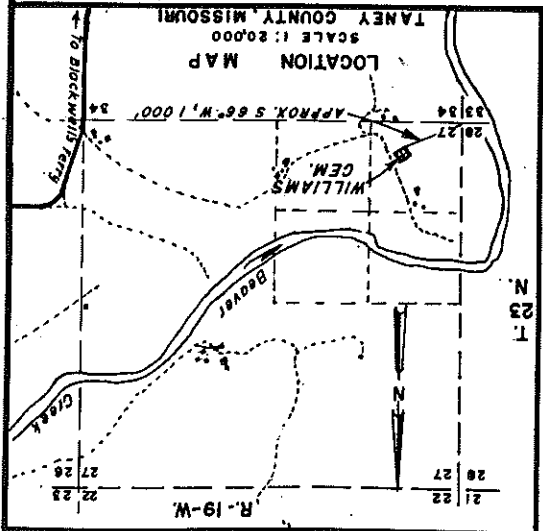